

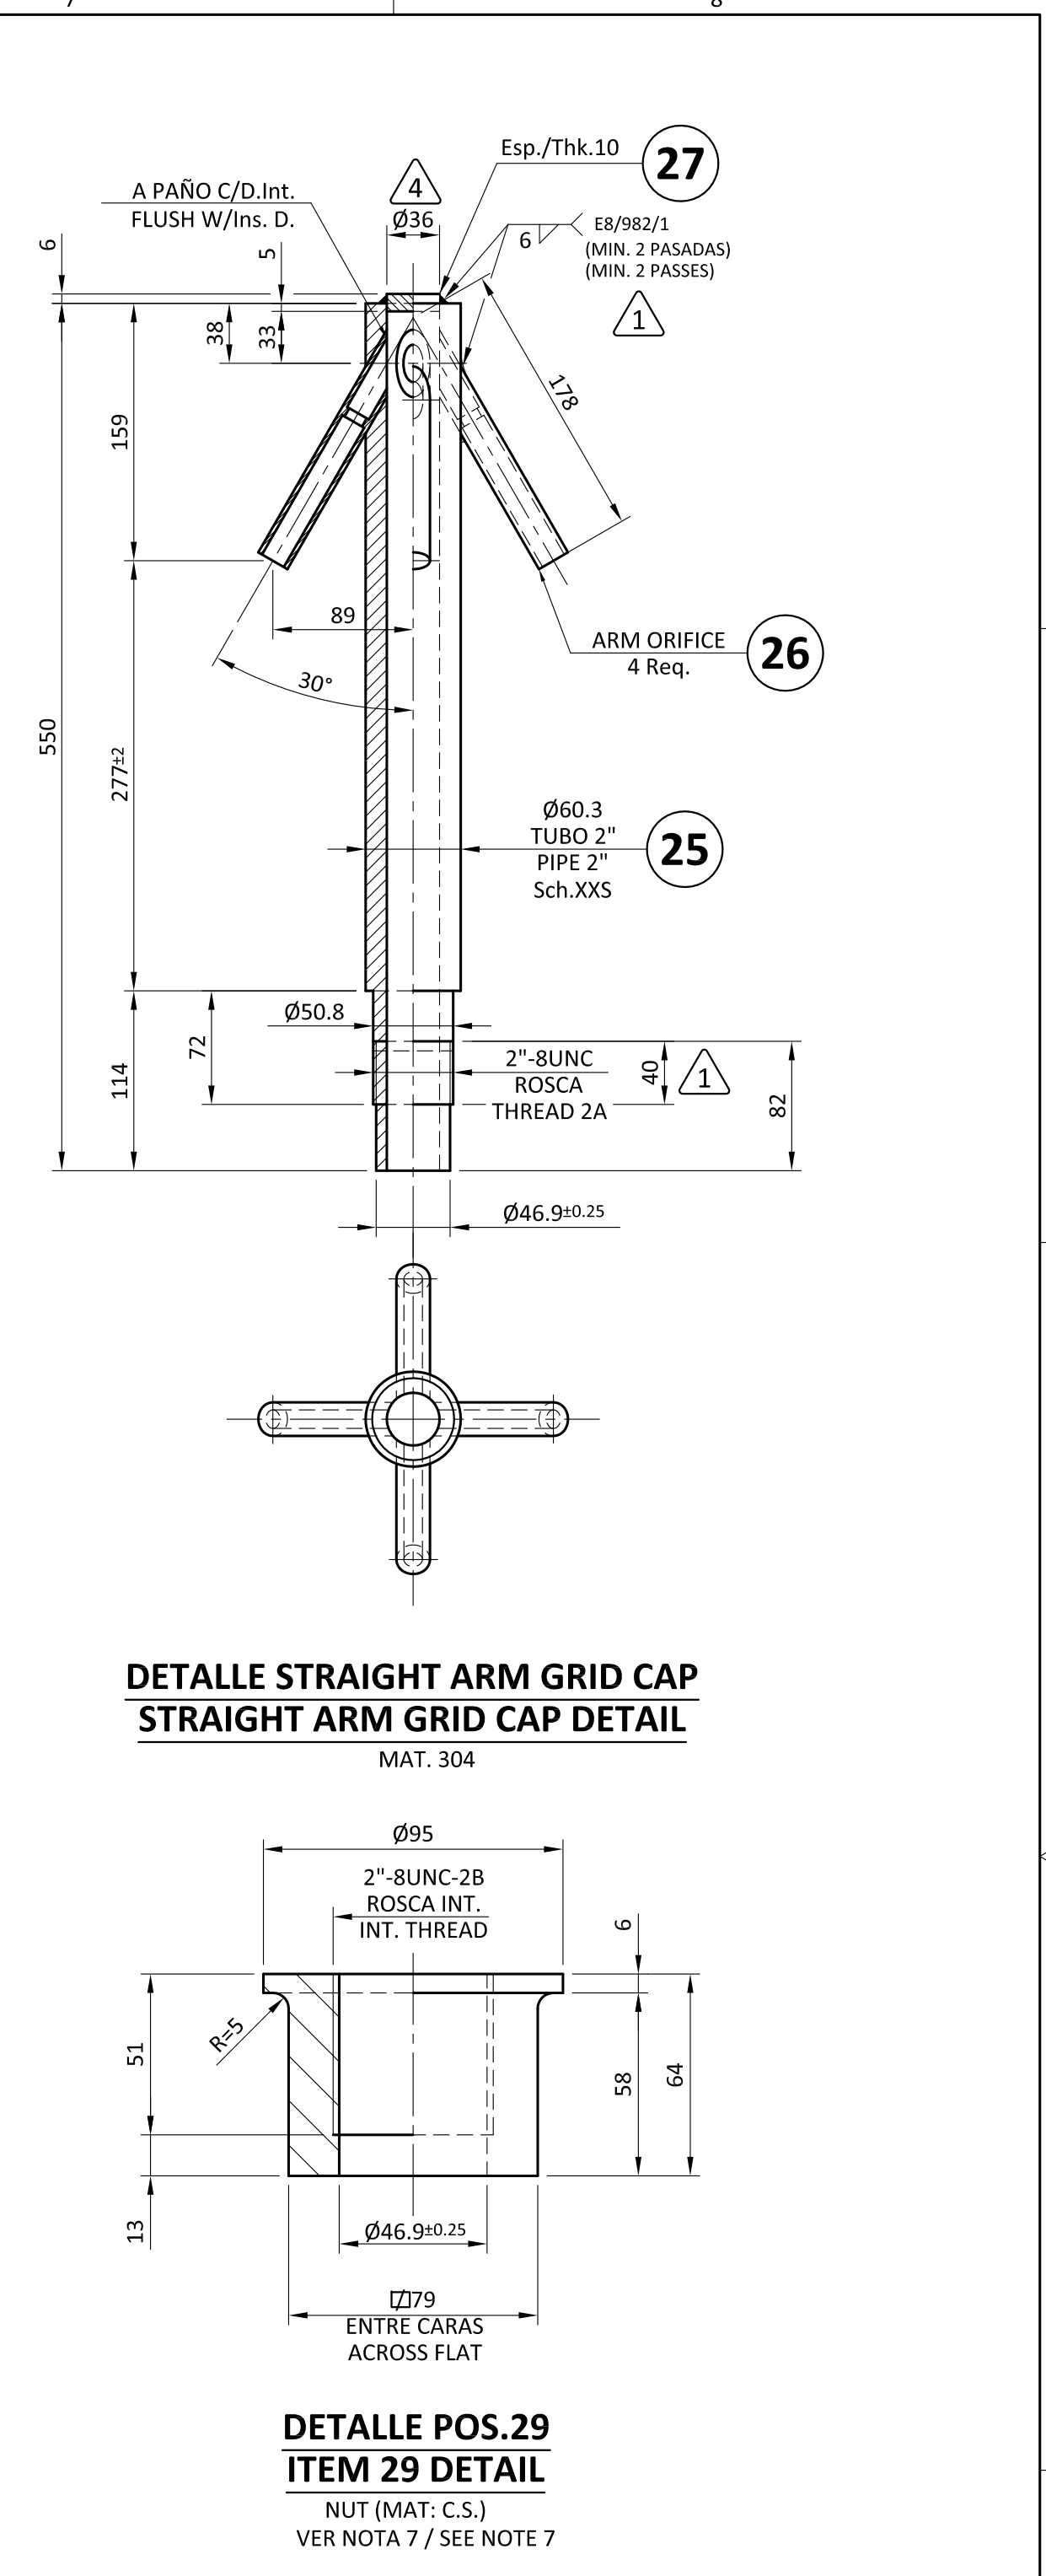
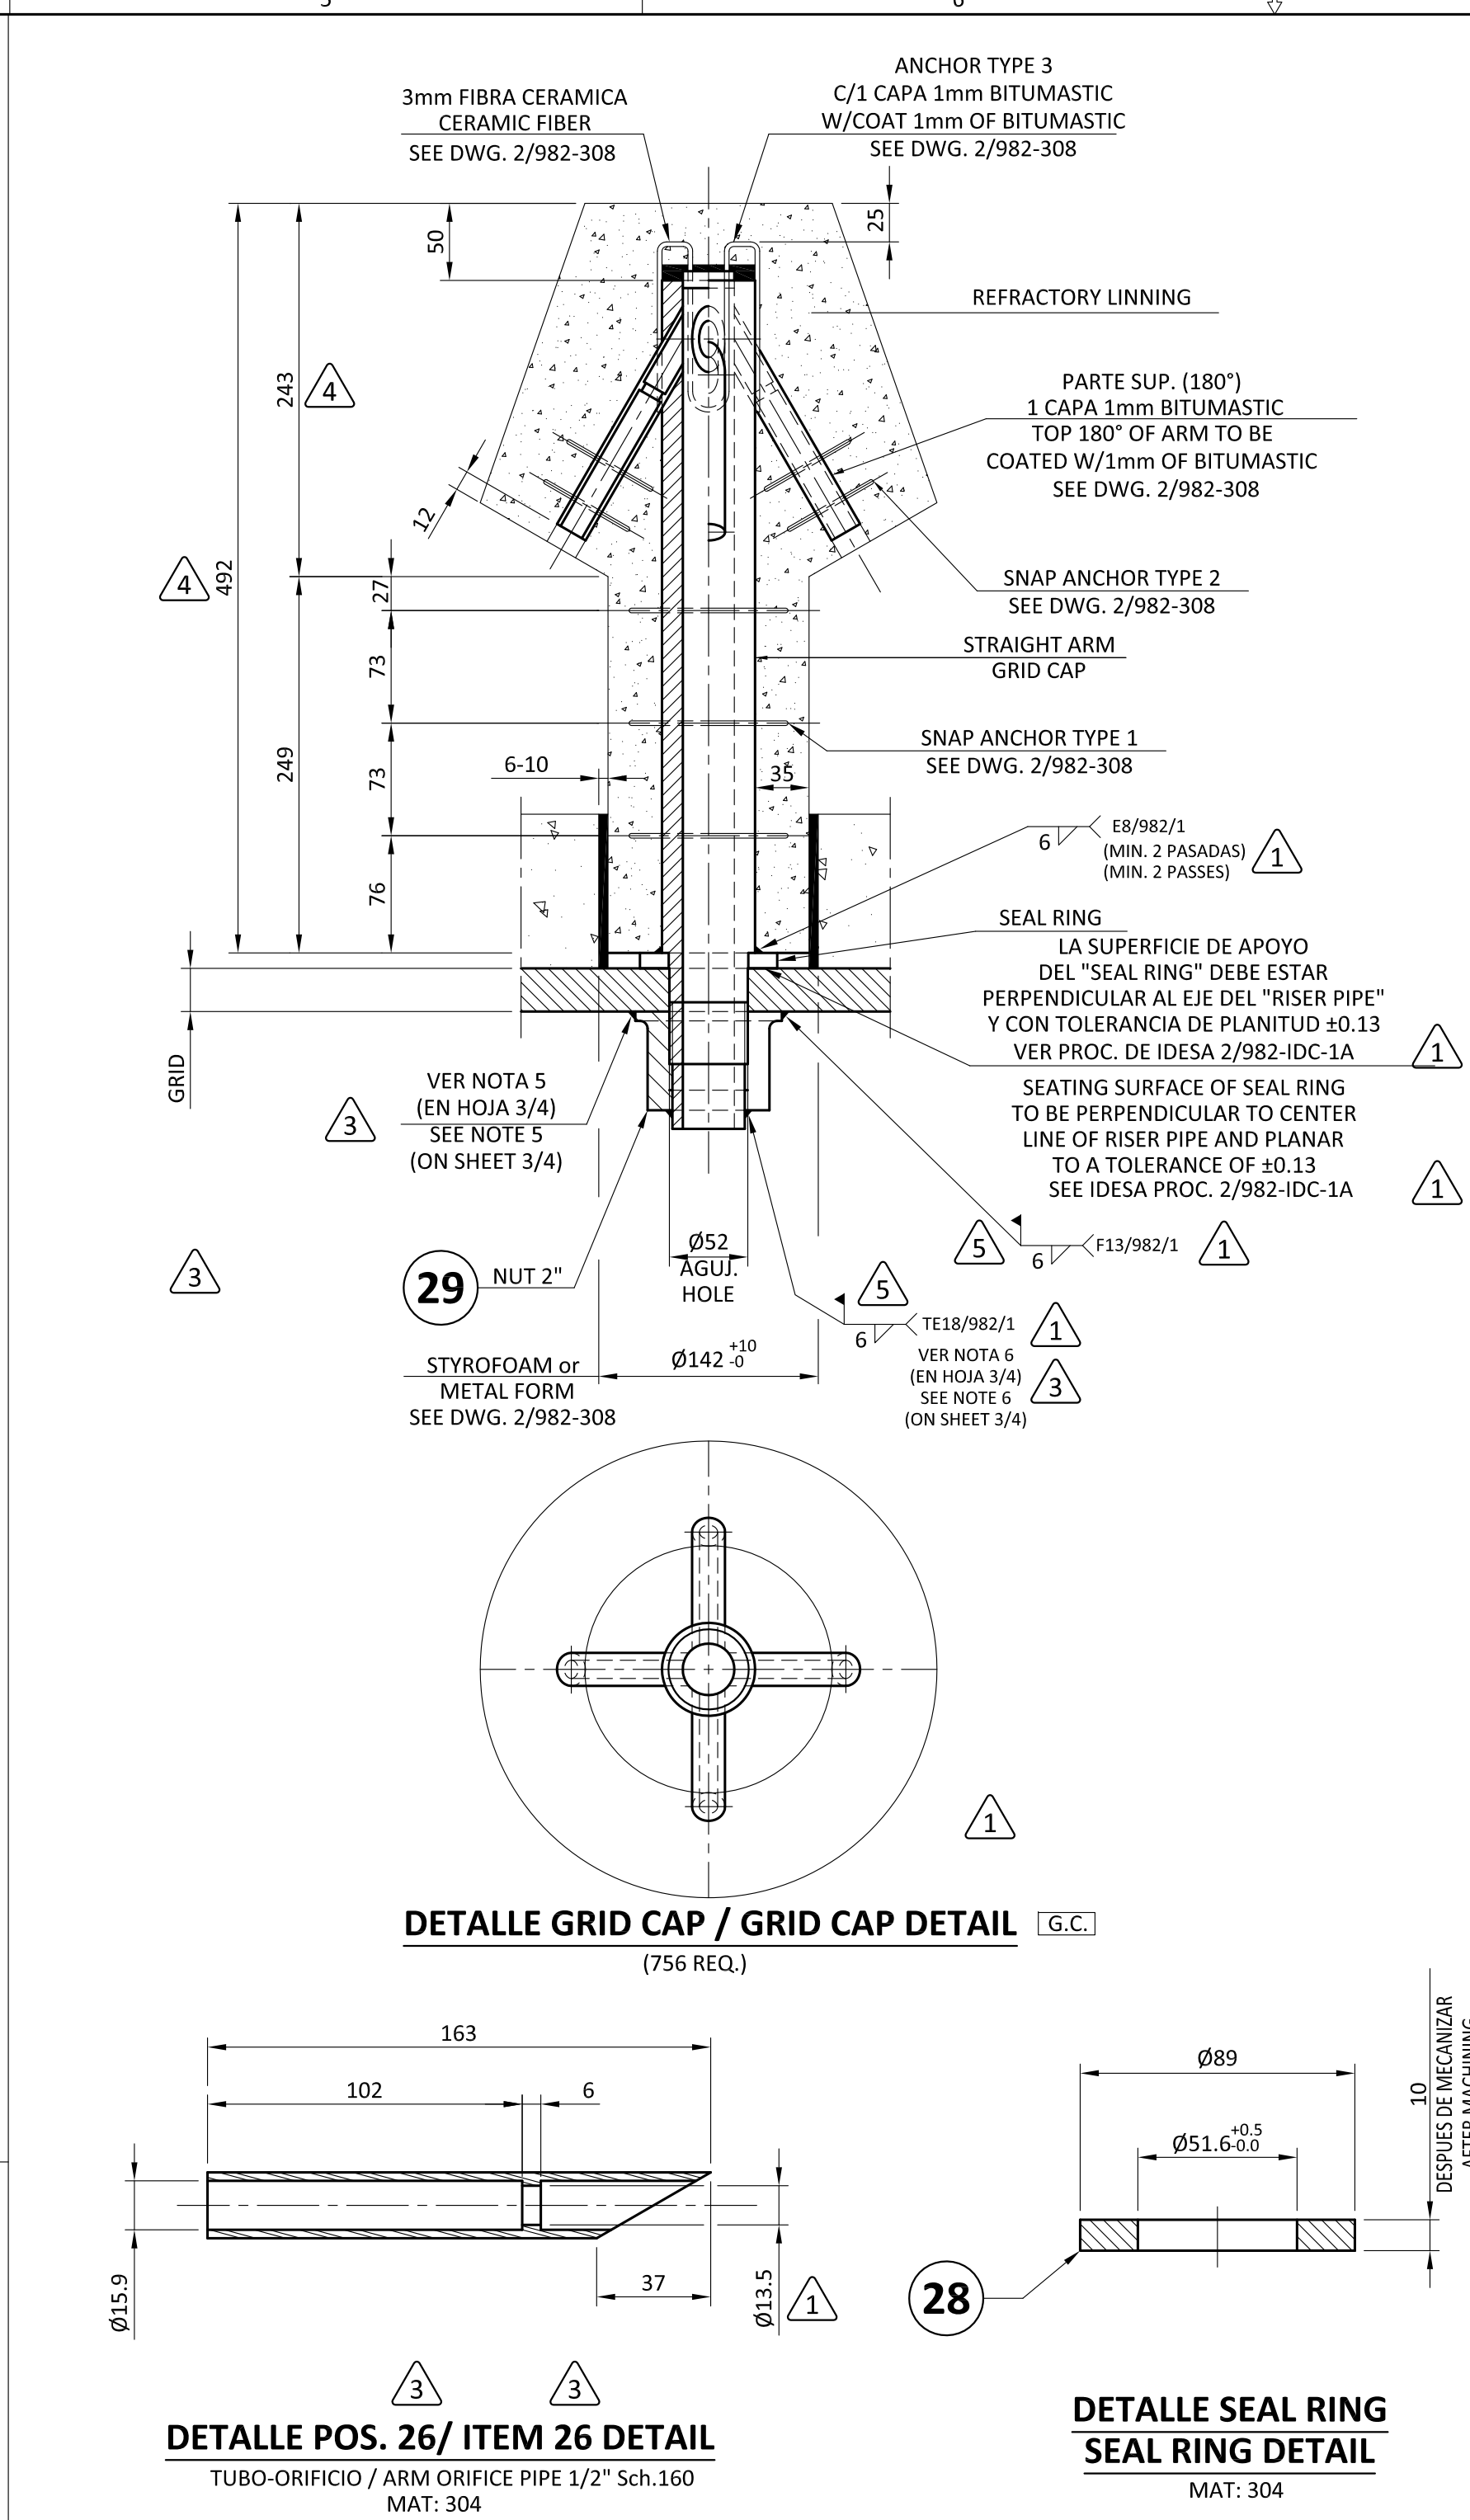
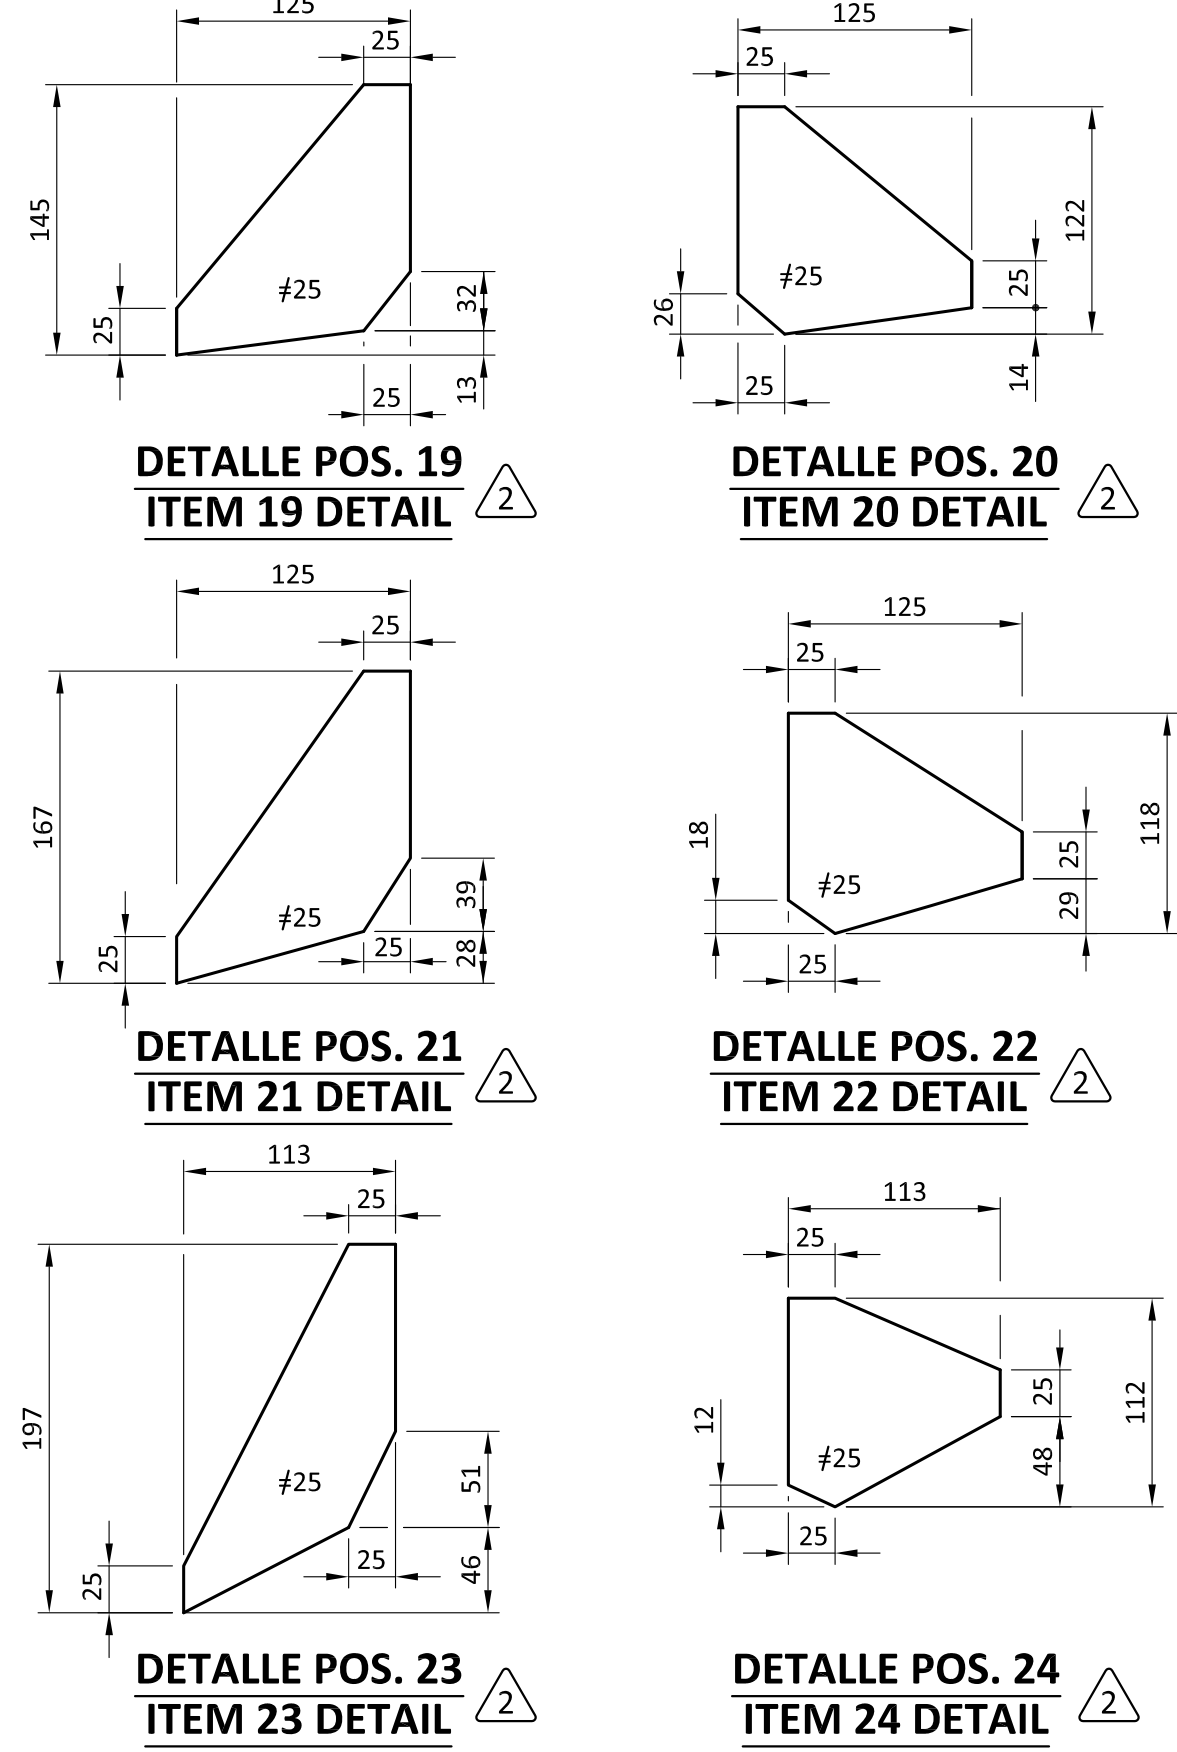


DIMENSION / DIMENSION	>2000	>1000	>515	>120	>30	>6	66	
MECANIZADO TIPO MEDIO/MEDIUM MACHING	±1.2	±0.8	±0.5	±0.3	±0.2	±0.1	±0.1	
ELEMENTO SOLDADO/WELDED STRUCTURE	±7	±5	±4	±3	±2	±1	±0.5	
TOLERANCIAS GENERALES GENERAL TOLERANCES								
PROYECCION/PROJECTION								

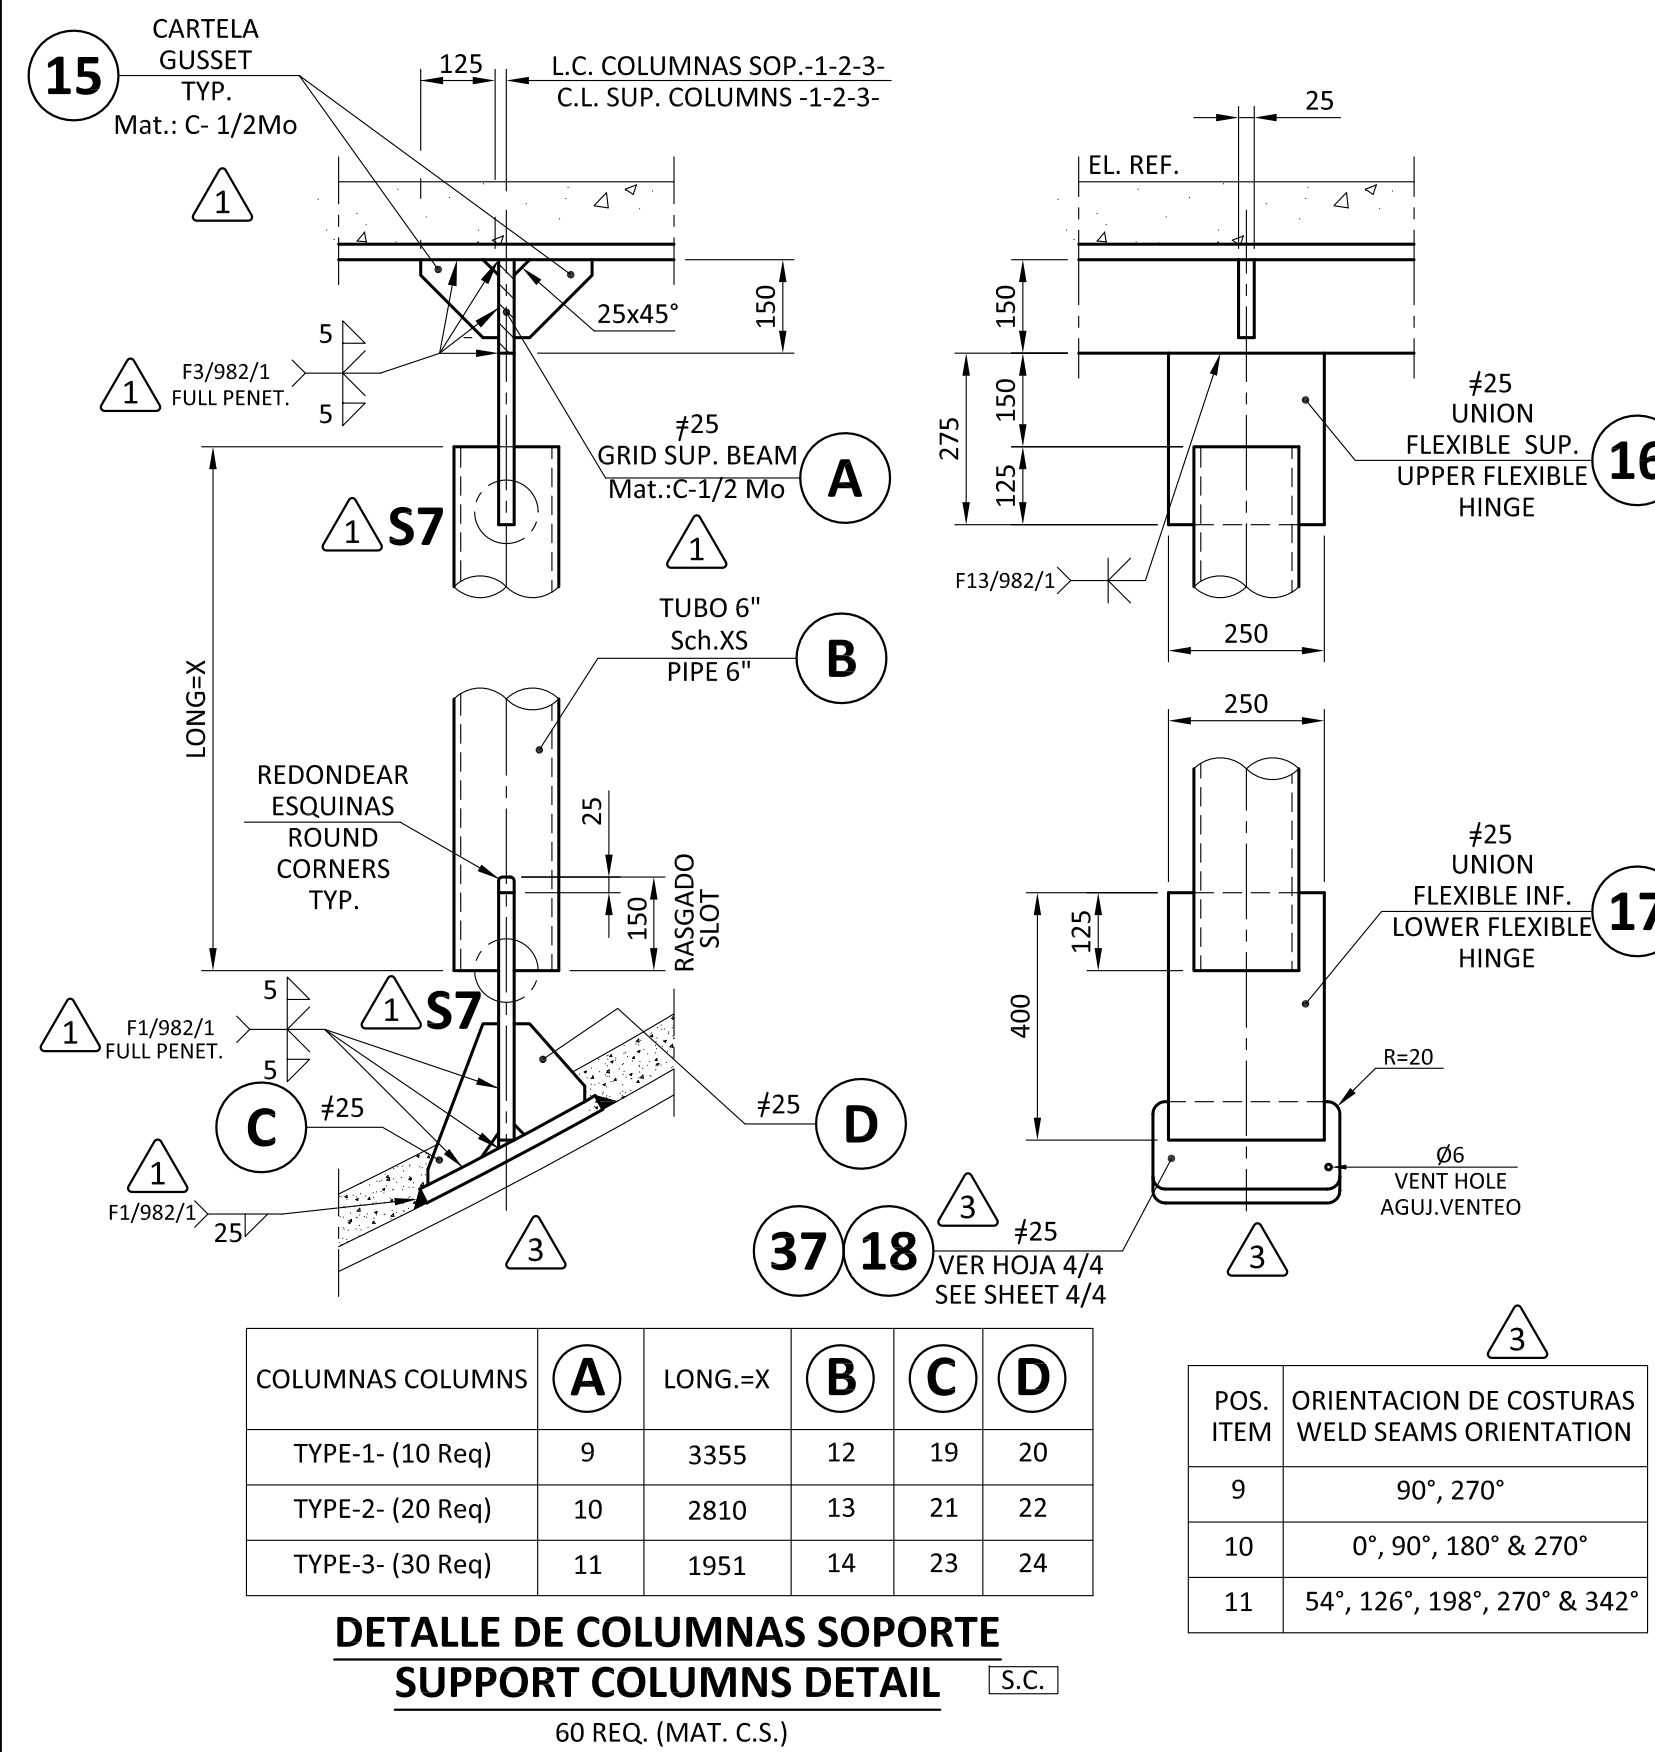

MODERNIZACION REFINERIA de TALARA		PETROPERU, S.A.	
			
PROJECT: MODERNIZACION REFINERIA DE TALARA		CONTRAC TR PROJECT N°: 02070	
PURCHASE ORDER No. 020700342-I213		EQUIPMENTS / TAGS No. FCK-R-103	
DOCUMENT CODE : PLD-0001		DOCUMENT No. V-020700342-I213-FCK-R-103-007-F	
REVIEW RESPONSE BY PURCHASER :			
☐ REJECTED ☐ COMMENTS AS NOTED ☐ VOID ☐ REVIEWED WITH COMMENTS ☐ REVIEWED AS BUILT ☒ REVIEWED WITHOUT COMMENTS ☐ FOR INFORMATION			
DATE: 16/11/2016			
VENDOR IDENTIFICATION :		IDESA	
DOCUMENT TITLE :		GRID DETAILS	
VENDOR DOCUMENT NUMBER		2/982-307 (2/4)	
		Rev. 5	

5	DONDE SE INDICA / AS INDICATED	06.10.16	Juan D.	06.10.16	SOLEDAD	06.10.16	BEGOÑA
4	DONDE SE INDICA / AS INDICATED	11.04.16	JUAN D.	11.04.16	SOLEDAD	11.04.16	BEGOÑA
3	DONDE SE INDICA / AS INDICATED	12.02.16	JUAN D.	12.02.16	SOLEDAD	12.02.16	BEGOÑA
2	DONDE SE INDICA / AS INDICATED	19.10.15	JUAN D.	19.10.15	SOLEDAD	19.10.15	BEGOÑA
1	DONDE SE INDICA	10.08.15	JUAN D.	10.08.15	SOLEDAD	10.08.15	BEGOÑA
REV.	OBJETO DE LA REVISION Subject of Revision	DATE ISSUED (D)	SIGNAT.	DATE REVIEWED (Pr.E.)	SIGNAT.	DATE APPROVED (T.M.)	SIGNAT.
CLIENTE: T.R. /PETROPERU		N°. ORDEN: 2/982					
OBRA: FLEXICOKING GASIFIER (FCK-R-103)							
DESIGNACION: DETALLES DEL GRID GRID DETAILS							
PLANO N°: 2/982-307 (2/4)		REV. 5		SIZE A1			
VENDOR DOCUMENT NUMBER 2/982-307 (2/4)		Rev. 5		SCALE 1:60			

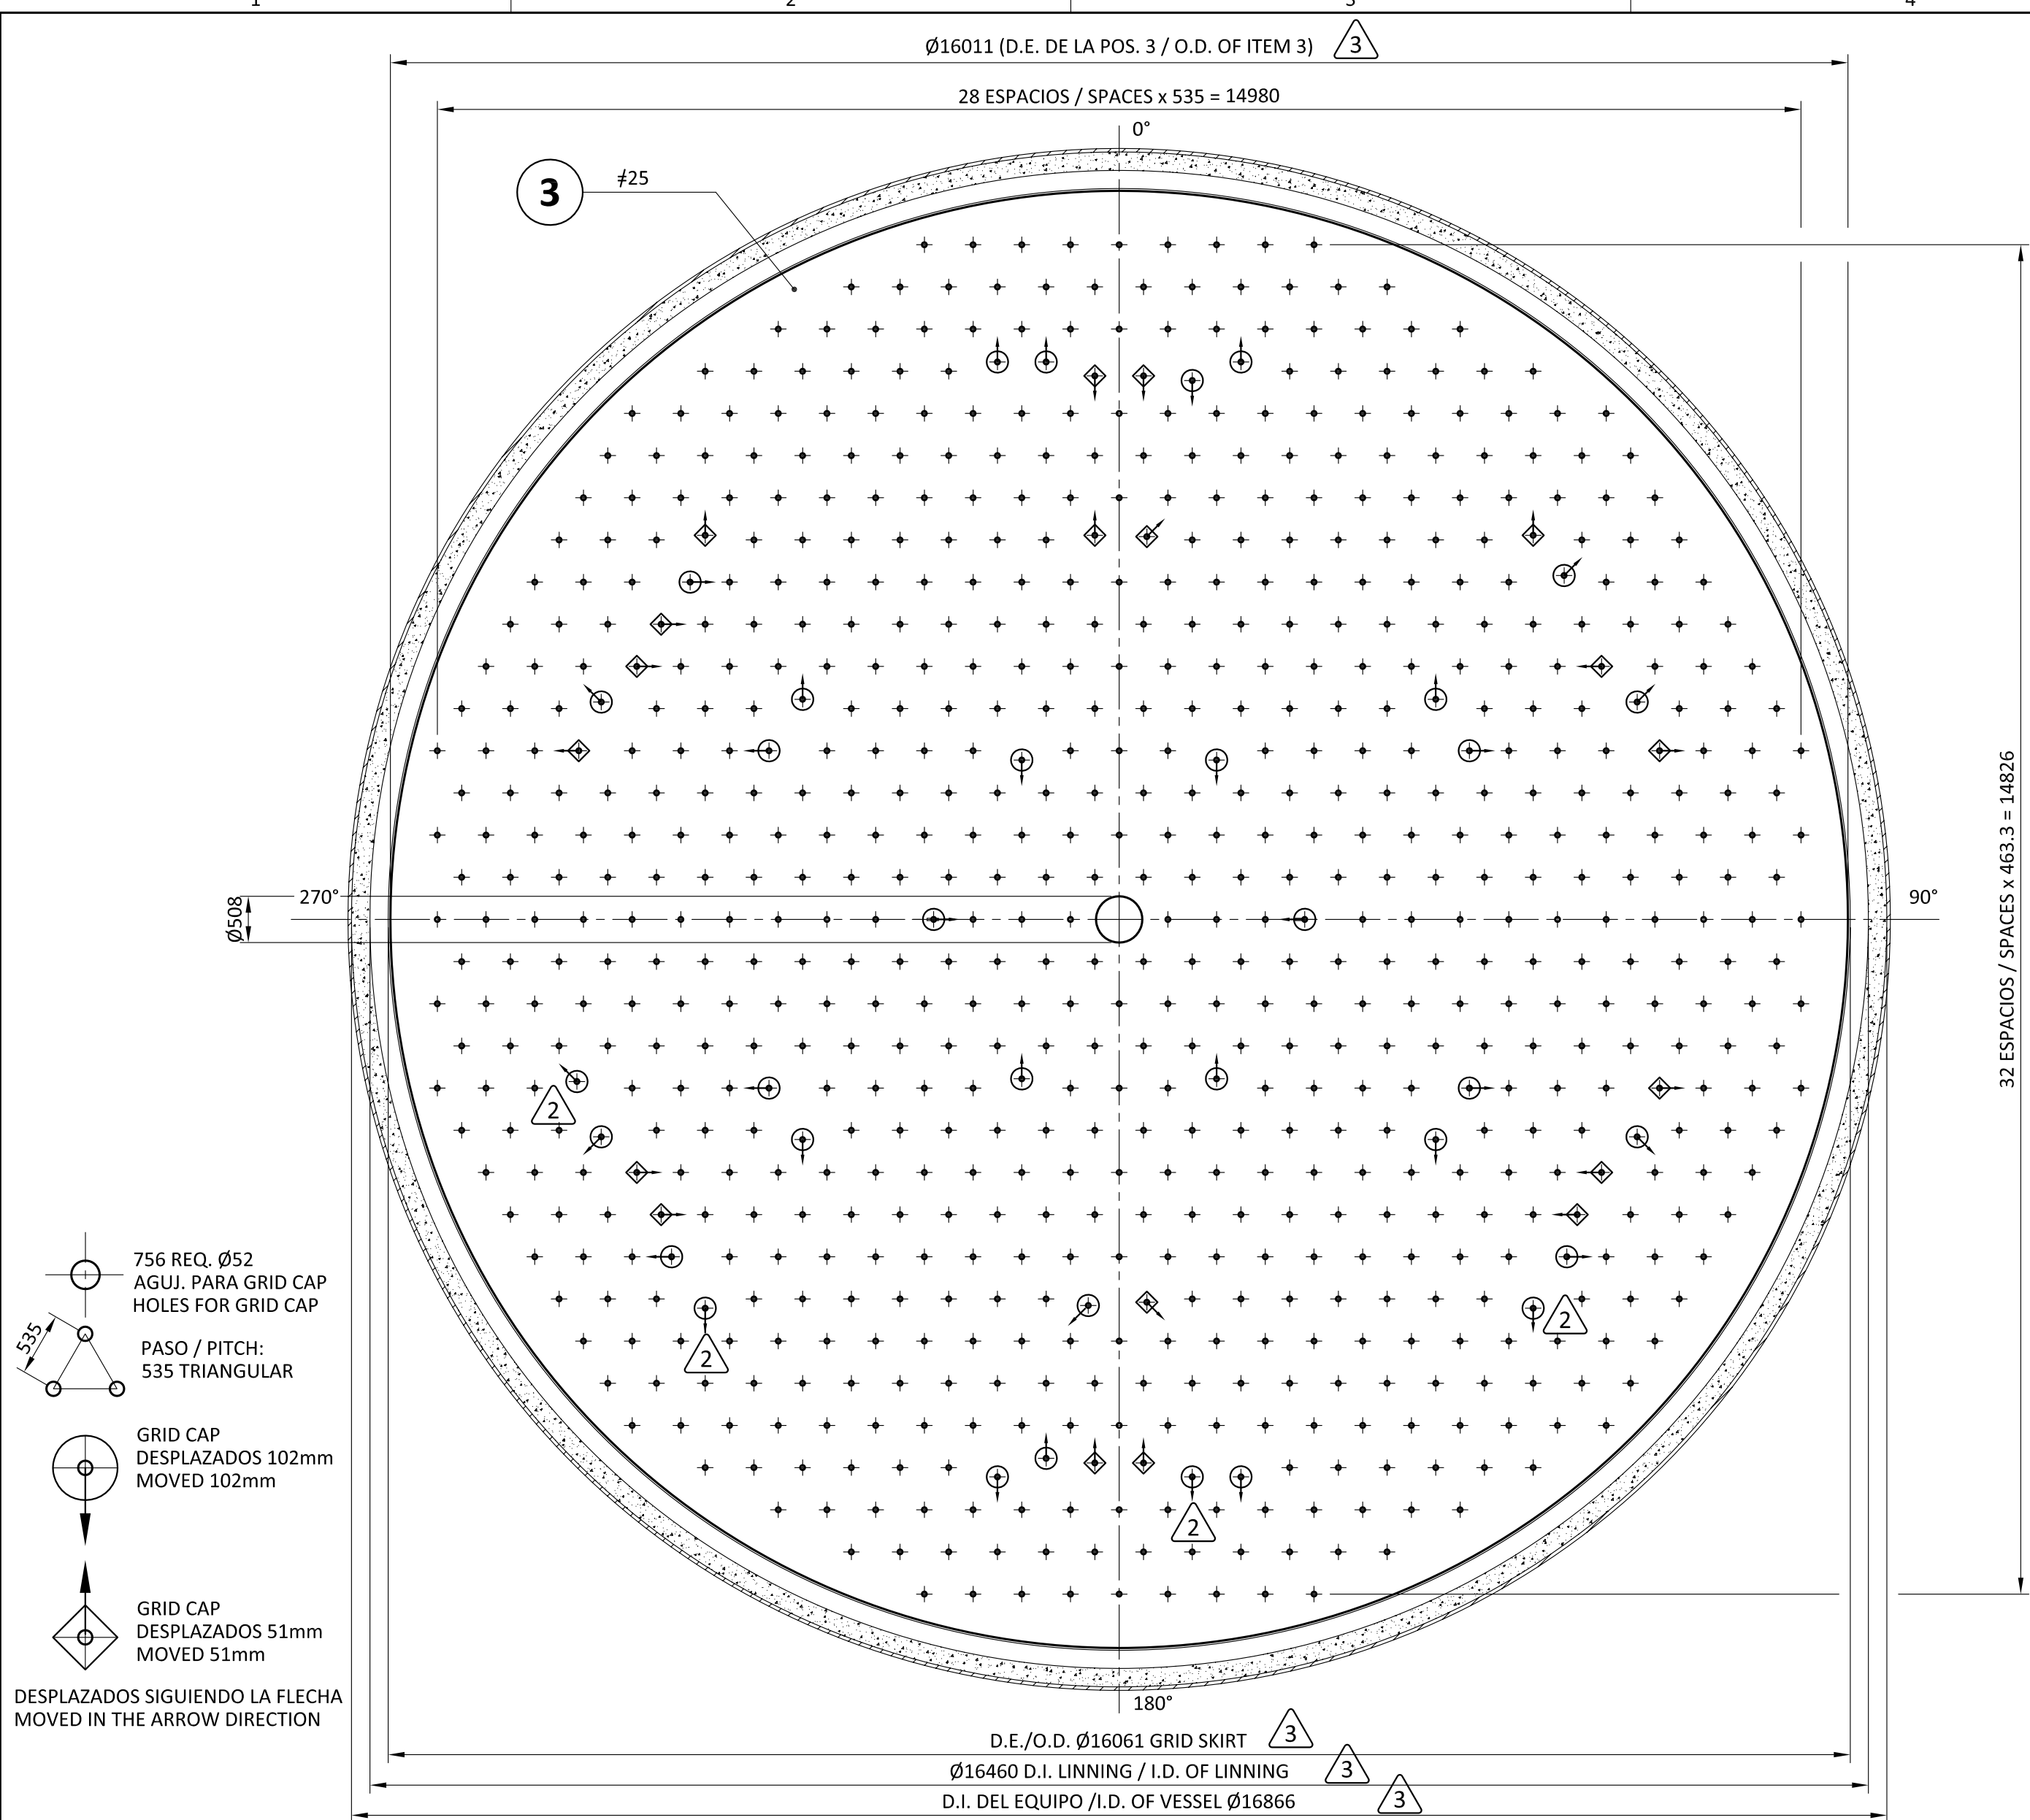